

ENGINEER'S CERTIFICATION

I, _____, hereby certify that:

- The information contained in this drawing / document is in compliance with approved drawings and design.
- The new water and sewerage works defined by this drawing have been designed and constructed in accordance with the SEQ Code.
- This represents an accurate record of as-constructed works.
- I accept responsibility for the information contained in this drawing / document.


RPEQ (signature) RPEQ No. _____ Date: _____

REGISTERED SURVEYOR'S CERTIFICATION

I, Christopher Klibbe, hereby certify that the vertical and horizontal locations and dimensions shown on this plan are a true and correct record and were located by survey.

NORRIS CLARKE & O'BRIEN PTY LTD
 Registered Surveyor (sig) No. 12321 Date: 08/04/22

AS CONSTRUCTED

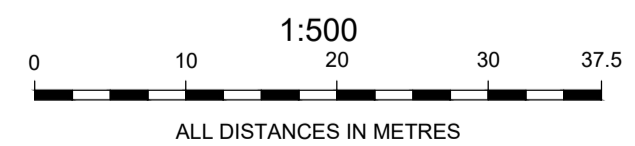

A1	0	08/04/2022	ORIGINAL ISSUE	BD	CK	CK
	INDEX	DATE	REVISIONS	DRAWN	CHECKED	PASSED

DRAWN	BD	08/04/2022
CHECKED	CK	08/04/2022
PASSED	CK	08/04/2022
INITIALS	DATE	

Norris Clarke & O'Brien Pty Ltd
 Licensed Surveyors
 Town Planners
 Development Consultants

Level 1 - Aldi Centre, 12 Bishop Street
 Kelvin Grove QLD 4059
 ph: 07 3012 0000 fax: 07 3012 0099
 email: info@ncob.com.au
 ACN 056 870 770 ABN 15 056 870 770

Brisbane City Council

CANNON HILL COMMUNITY LINKS ESTATE
 FINISHED SURFACE LEVELS AS CONSTRUCTED - STAGE 5
 1701, 1733 & 1825 CREEK ROAD, CANNON HILL -

SCALE	1:500
SHEET 1	OF 1 SHEETS
DRAWING NO.	6622AC-5-FSL