


ENGINEER'S CERTIFICATION
 I, PETER INGERMAN - RPEQ 9424 17/05/22 *PK*
 being a Consulting Engineer and duly authorised representative of -
 EMPOWER ENGINEERS AND PROJECT MANAGERS
 hereby:-
 # certify the information contained in this drawing is an accurate "as constructed" representation of the works;
 # accept responsibility for the "as constructed" information contained in this drawing; and
 # acknowledge the "as constructed" information contained in the drawing may be relied on by the BRISBANE CITY COUNCIL and others.

REGISTERED SURVEYOR'S CERTIFICATION
 I, Christopher Klibbe, hereby certify that the vertical and horizontal locations and dimensions shown on this plan are a true and correct record and were located by survey.
 NORRIS CLARKE & O'BRIEN PTY LTD
 CR 056 870 770
 Registered Surveyor (sig.) No. 4231 Date: 08/04/22

AS CONSTRUCTED

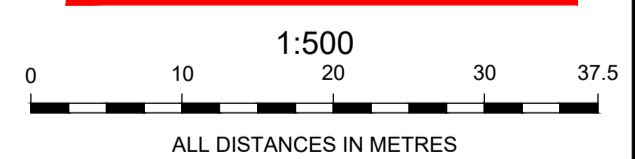

A1	0	08/04/2022	ORIGINAL ISSUE	BD	CK	CK
	INDEX	DATE	REVISIONS	DRAWN	CHECKED	PASSED

Norris Clarke & O'Brien Pty Ltd
 Licensed Surveyors
 Town Planners
 Development Consultants

Level 1 - Aldi Centre, 12 Bishop Street
 Kelvin Grove QLD 4059
 ph: 07 3012 0000 fax: 07 3012 0099
 email: info@ncob.com.au
 ACN 056 870 770 ABN 15 056 870 770

Brisbane City Council

CANNON HILL COMMUNITY LINKS ESTATE
 STORMWATER AS CONSTRUCTED - STAGE 5
 1701, 1733 & 1825 CREEK ROAD, CANNON HILL -

SCALE 1:500
 SHEET 1 OF 1 SHEETS
 DRAWING NO. 6622AC-5-SW