

ENGINEERS CERTIFICATION OF AS CONSTRUCTED WORKS

I, **PETER INGERMAN**, HEREBY CERTIFY THAT:

1. THE INFORMATION IN THIS DRAWING IS IN COMPLIANCE WITH THE APPROVED DRAWINGS AND DESIGN.
2. THE NEW WATER METER AND SEWERAGE WORKS DEFINED BY THIS DRAWING HAVE BEEN DESIGNED AND CONSTRUCTED IN ACCORDANCE WITH THE SEQ CODE.
3. THIS REPRESENTS AN ACCURATE RECORD OF AS CONSTRUCTED WORKS.
4. SURVEY PICKUP WAS UNDERTAKEN BY NORRIS CLARKE & O'BRIEN PTY LTD ABN 15056870770

COMPANY
EMPOWER ENGINEERS AND PROJECT MANAGERS PTY LTD
 RPEQ No. **9424**
 SIGNATURE *Peter Ingerman*
 DATE 31/1/2022


REGISTERED SURVEYOR'S CERTIFICATION
 I, **Christopher Klippe**, hereby certify that the vertical and horizontal locations and dimensions shown on this plan are a true and correct record and were located by survey.
NORRIS CLARKE & O'BRIEN PTY LTD
 ACN 056 870 770
 Registered Surveyor (sig) No. 2221 Date: 24/01/22

SEE INSET

Note: All Sewer Mains 160PE SD21 PN8 unless shown otherwise

INSET

AS CONSTRUCTED

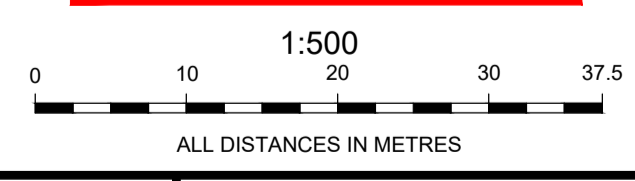

A1	0	24/01/22	ORIGINAL ISSUE						
	INDEX	DATE	REVISIONS	DRAWN	CHECKED	PASSED	DRAWN	CHECKED	PASSED

Norris Clarke & O'Brien Pty Ltd
 Licensed Surveyors
 Town Planners
 Development Consultants
 Level 1 - Aldi Centre, 12 Bishop Street
 Kelvin Grove QLD 4059
 ph: 07 3012 0000 fax: 07 3012 0099
 email: info@ncob.com.au
 ACN 056 870 770 ABN 15 056 870 770

QUEENSLAND UrbanUtilities

Queensland Urban Utilities
 CANNON HILL COMMUNITY LINKS ESTATE
 SEWER AS CONSTRUCTED - STAGE 5
 1701, 1733 & 1825 CREEK ROAD, CANNON HILL - QUJ 21-PNT-50238

SCALE	1:500
SHEET 1 OF 1 SHEETS	
DRAWING NO.	6622AC-5-SEW