


ENGINEER'S CERTIFICATION

I, _____, hereby certify that:
1. The information contained in this drawing / document is in compliance with approved drawings and design.
2. The new water and sewerage works defined by this drawing have been designed and constructed in accordance with the SEQ Code.
3. This represents an accurate record of as-constructed works.
4. I accept responsibility for the information contained in this drawing / document.
RPEQ (signature) RPEQ No. _____ Date: _____

REGISTERED SURVEYOR'S CERTIFICATION

I, Christopher O'Brien, hereby certify that the vertical and horizontal locations and dimensions shown on this plan are a true and correct record and were located by survey.
NORRIS CLARKE & O'BRIEN PTY LTD
ACN 056 870 770
Registered Surveyor (sign) Reg. Surveyor No. 4491 Date: 19/12/23

AS CONSTRUCTED

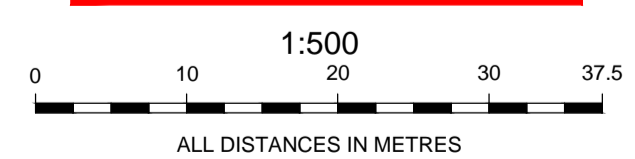

Note: All Sewer Mains 160PE SD21 PN8 unless shown otherwise

A1

INDEX	DATE	REVISIONS	DRAWN	CHECKED	PASSED
0	19/12/23	ORIGINAL ISSUE	GWH	LOB	



DRAWN	CHECKED	PASSED	INITIALS	DATE

Norris Clarke & O'Brien Pty Ltd
 Licensed Surveyors
 Town Planners
 Development Consultants
 Level 1 - Aldi Centre, 12 Bishop Street
 Kelvin Grove QLD 4059
 ph: 07 3012 0000 fax: 07 3012 0099
 email: info@ncob.com.au
 ACN 056 870 770 ABN 15 056 870 770



Queensland Urban Utilities
 CANNON HILL COMMUNITY LINKS ESTATE
 SEWER AS CONSTRUCTED - STAGE 5A
 42,44 & 48 SUTTON PLACE, CANNON HILL - UJ 23-PNT-65398

SCALE	1:500
SHEET 1	OF 1 SHEETS
DRAWING NO.	11378-AC-SEW

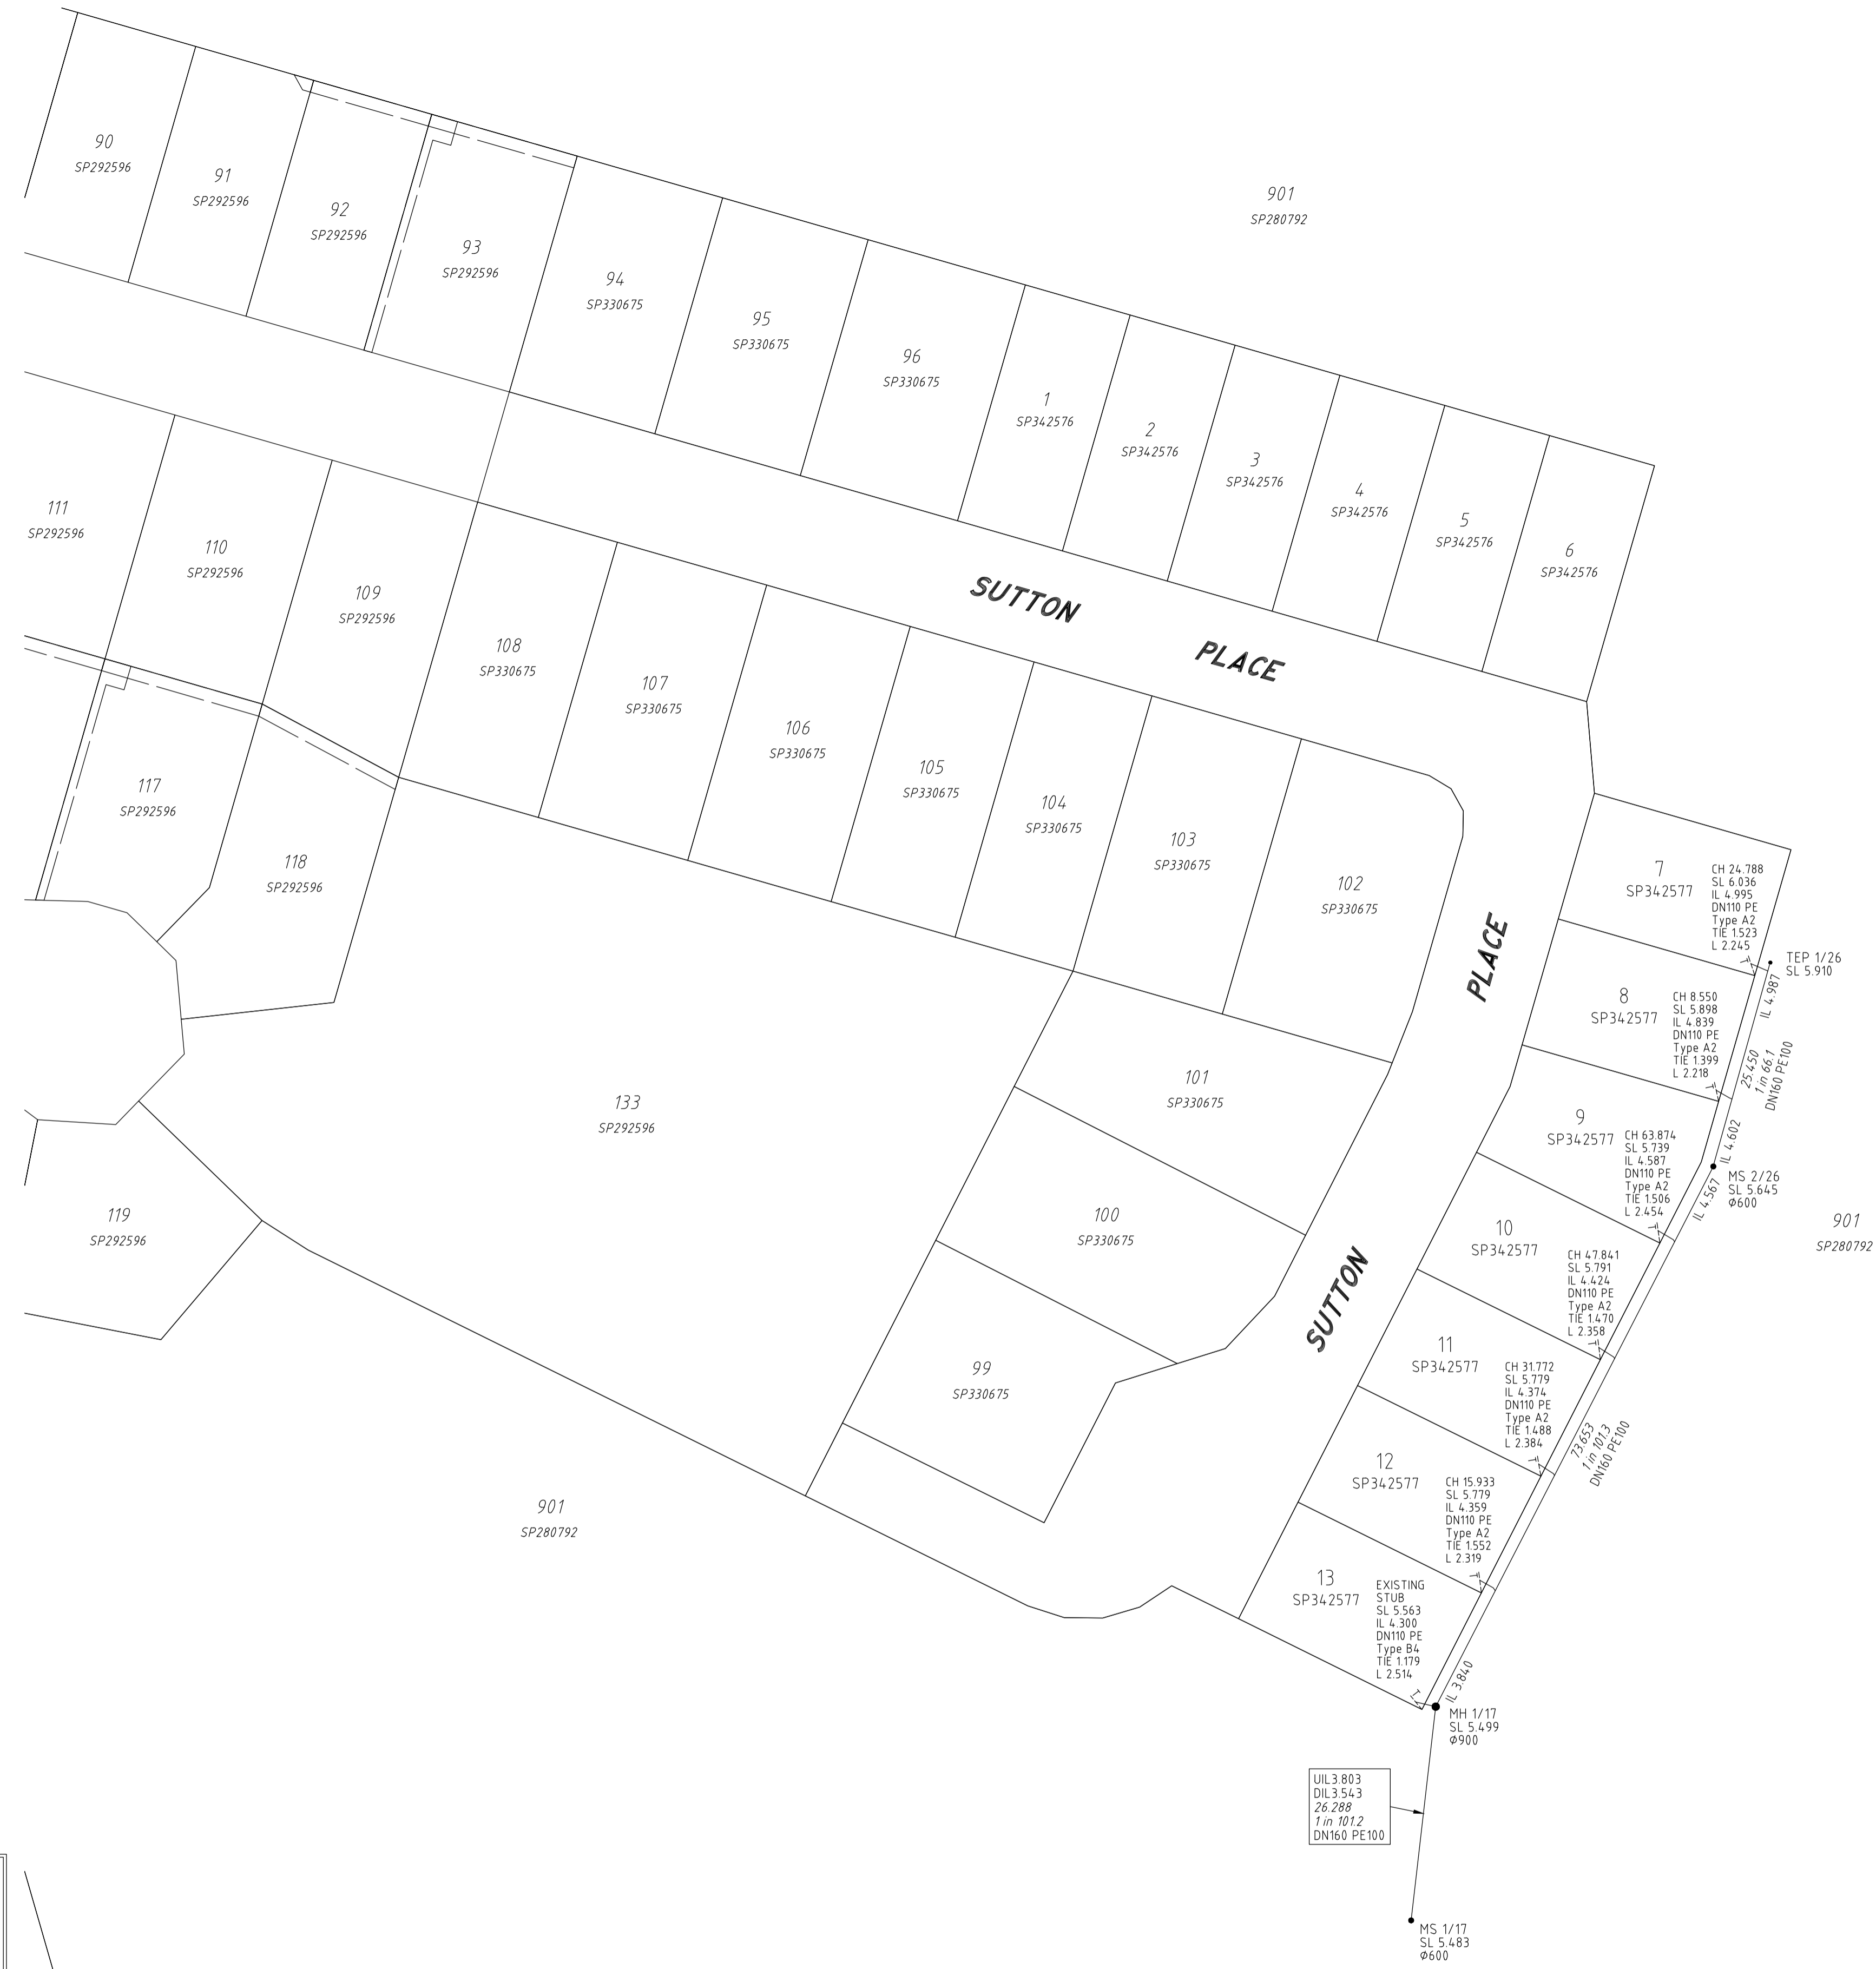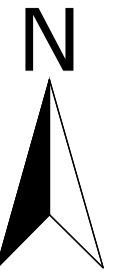

ENGINEER'S CERTIFICATION

I, _____, hereby certify that:
 1. The information contained in this drawing / document is in compliance with approved drawings and design.
 2. The new water and sewerage works defined by this drawing have been designed and constructed in accordance with the SEQ Code.
 3. This represents an accurate record of as-constructed works.
 4. I accept responsibility for the information contained in this drawing / document.

RPEQ (signature) RPEQ No. _____ Date: _____


REGISTERED SURVEYOR'S CERTIFICATION

I, Christopher Clarke, hereby certify that the vertical and horizontal locations and dimensions shown on this plan are a true and correct record and were located by survey.

NORRIS CLARKE & O'BRIEN PTY LTD
 Registered Surveyors
 Reg. Surveyor No. 4491 Date: 19/12/23

Note: All Sewer Mains 160PE SD21 PN8 unless shown otherwise

AS CONSTRUCTED

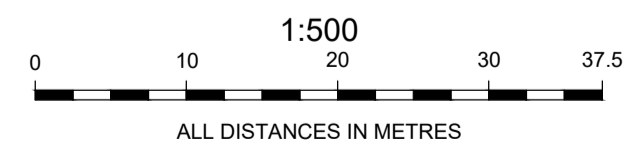

A1

INDEX	DATE	REVISIONS	DRAWN	CHECKED	PASSED
0	19/12/23	ORIGINAL ISSUE	GWH	LOB	

DRAWN	CHECKED	PASSED	INITIALS	DATE

Norris Clarke & O'Brien Pty Ltd
 Licensed Surveyors
 Town Planners
 Development Consultants

Level 1 - Aldi Centre, 12 Bishop Street
 Kelvin Grove QLD 4059
 ph: 07 3012 0000 fax: 07 3012 0099
 email: info@ncob.com.au
 ACN 056 870 770 ABN 15 056 870 770



Queensland Urban Utilities

CANNON HILL COMMUNITY LINKS ESTATE
 SEWER AS CONSTRUCTED - STAGE 5B
 60 SUTTON PLACE, CANNON HILL - UU 23-PNT-65398

SCALE	1:500
SHEET 1 OF 1 SHEETS	
DRAWING NO.	11379AC-SEW