

ENGINEER'S CERTIFICATION

I, _____, hereby certify that:

- The information contained in this drawing / document is in compliance with approved drawings and design.
- The new water and sewerage works defined by this drawing have been designed and constructed in accordance with the SEQ Code.
- This represents an accurate record of as-constructed works.
- I accept responsibility for the information contained in this drawing / document.

RPEQ (signature) RPEQ No. _____ Date: _____

REGISTERED SURVEYOR'S CERTIFICATION


I, Christopher K. O'Brien, hereby certify that the vertical and horizontal locations and dimensions shown on this plan are a true and correct record and were located by survey.

NORRIS CLARKE & O'BRIEN PTY LTD
 Registered Surveyors (Sign) - Reg. Surveyor No. 4591 Date: 19/12/23

LEGEND

- w — Existing Main
- - - DN63 PE100 PN16 SDR11
- - - DN180 PE100 PN16 SDR11
- - - DN250 PE100 PN16 SDR11
- - - w - Conduit
- - - 25mm PE100 PN16 Services
- X Water Connection
- Fire Hydrant
- Stop Valve
- ⊗ Scour Valve

AS CONSTRUCTED

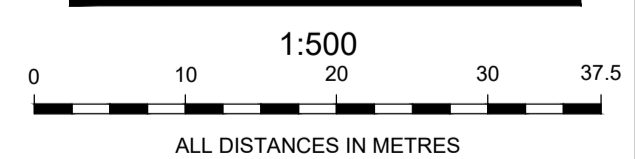

A1	0	19/12/23	ORIGINAL ISSUE						
	INDEX	DATE	REVISIONS	DRAWN	CHECKED	PASSED	INITIALS	DATE	

Norris Clarke & O'Brien Pty Ltd
 Licensed Surveyors
 Town Planners
 Development Consultants


Level 1 - Aldi Centre, 12 Bishop Street
 Kelvin Grove QLD 4059
 ph: 07 3012 0000 fax: 07 3012 0099
 email: info@ncob.com.au
 ACN 056 870 770 ABN 15 056 870 770



Queensland Urban Utilities

CANNON HILL COMMUNITY LINKS ESTATE
 WATER AS CONSTRUCTED - STAGE 5A
 42,44 & 48 SUTTON PLACE, CANNON HILL - UU 23-PNT-65398

SCALE	1:500
SHEET 1 OF 1 SHEETS	
DRAWING NO.	11378AC-WAT

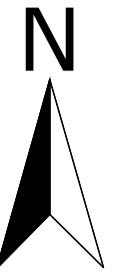


ENGINEER'S CERTIFICATION

I, _____, hereby certify that:
1. The information contained in this drawing / document is in compliance with approved drawings and design.
2. The new water and sewerage works defined by this drawing have been designed and constructed in accordance with the SEQ Code.
3. This represents an accurate record of as-constructed works
4. I accept responsibility for the information contained in this drawing / document.


RPEQ (signature) RPEQ No. _____ Date: _____

REGISTERED SURVEYOR'S CERTIFICATION

I, Christopher , hereby certify that the vertical and horizontal locations and dimensions shown on this plan are a true and correct record and were located by survey.
NORRIS CLARKE & O'BRIEN PTY LTD
Registered Surveyors (Sigs) - Reg. Surveyors No. 4491 Date: 19/12/23

- LEGEND**
- w — Existing Main
 - - - DN63 PE100 PN16 SDR11
 - - - DN180 PE100 PN16 SDR11
 - - - DN250 PE100 PN16 SDR11
 - - - w - Conduit
 - - - 25mm PE100 PN16 Services
 - X Water Connection
 - Fire Hydrant
 - M Stop Valve
 - ⊗ Scour Valve

AS CONSTRUCTED

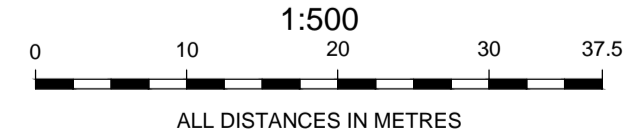

A1

INDEX	DATE	REVISIONS	DRAWN	CHECKED	PASSED
0	19/12/23	ORIGINAL ISSUE	GWH	LOB	

INITIALS	DATE

Norris Clarke & O'Brien Pty Ltd
Licensed Surveyors
Town Planners
Development Consultants

NCB

Level 1 - Aldi Centre, 12 Bishop Street
Kelvin Grove QLD 4059
ph: 07 3012 0000 fax: 07 3012 0099
email: info@ncob.com.au
ACN 056 870 770 ABN 15 056 870 770



**QUEENSLAND
UrbanUtilities**

Queensland Urban Utilities

CANNON HILL COMMUNITY LINKS ESTATE
WATER AS CONSTRUCTED - STAGE 5B
60 SUTTON PLACE, CANNON HILL - UU 23-PNT-65398

SCALE	1:500
SHEET 1	OF 1 SHEETS
DRAWING NO.	11379AC-WAT